
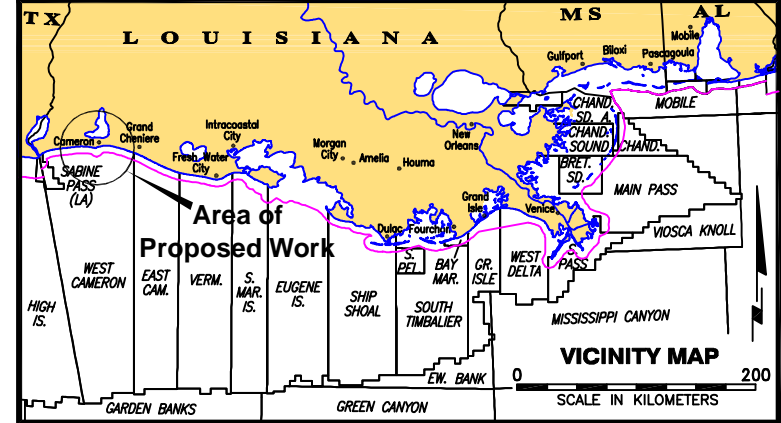


CAMERON PARISH

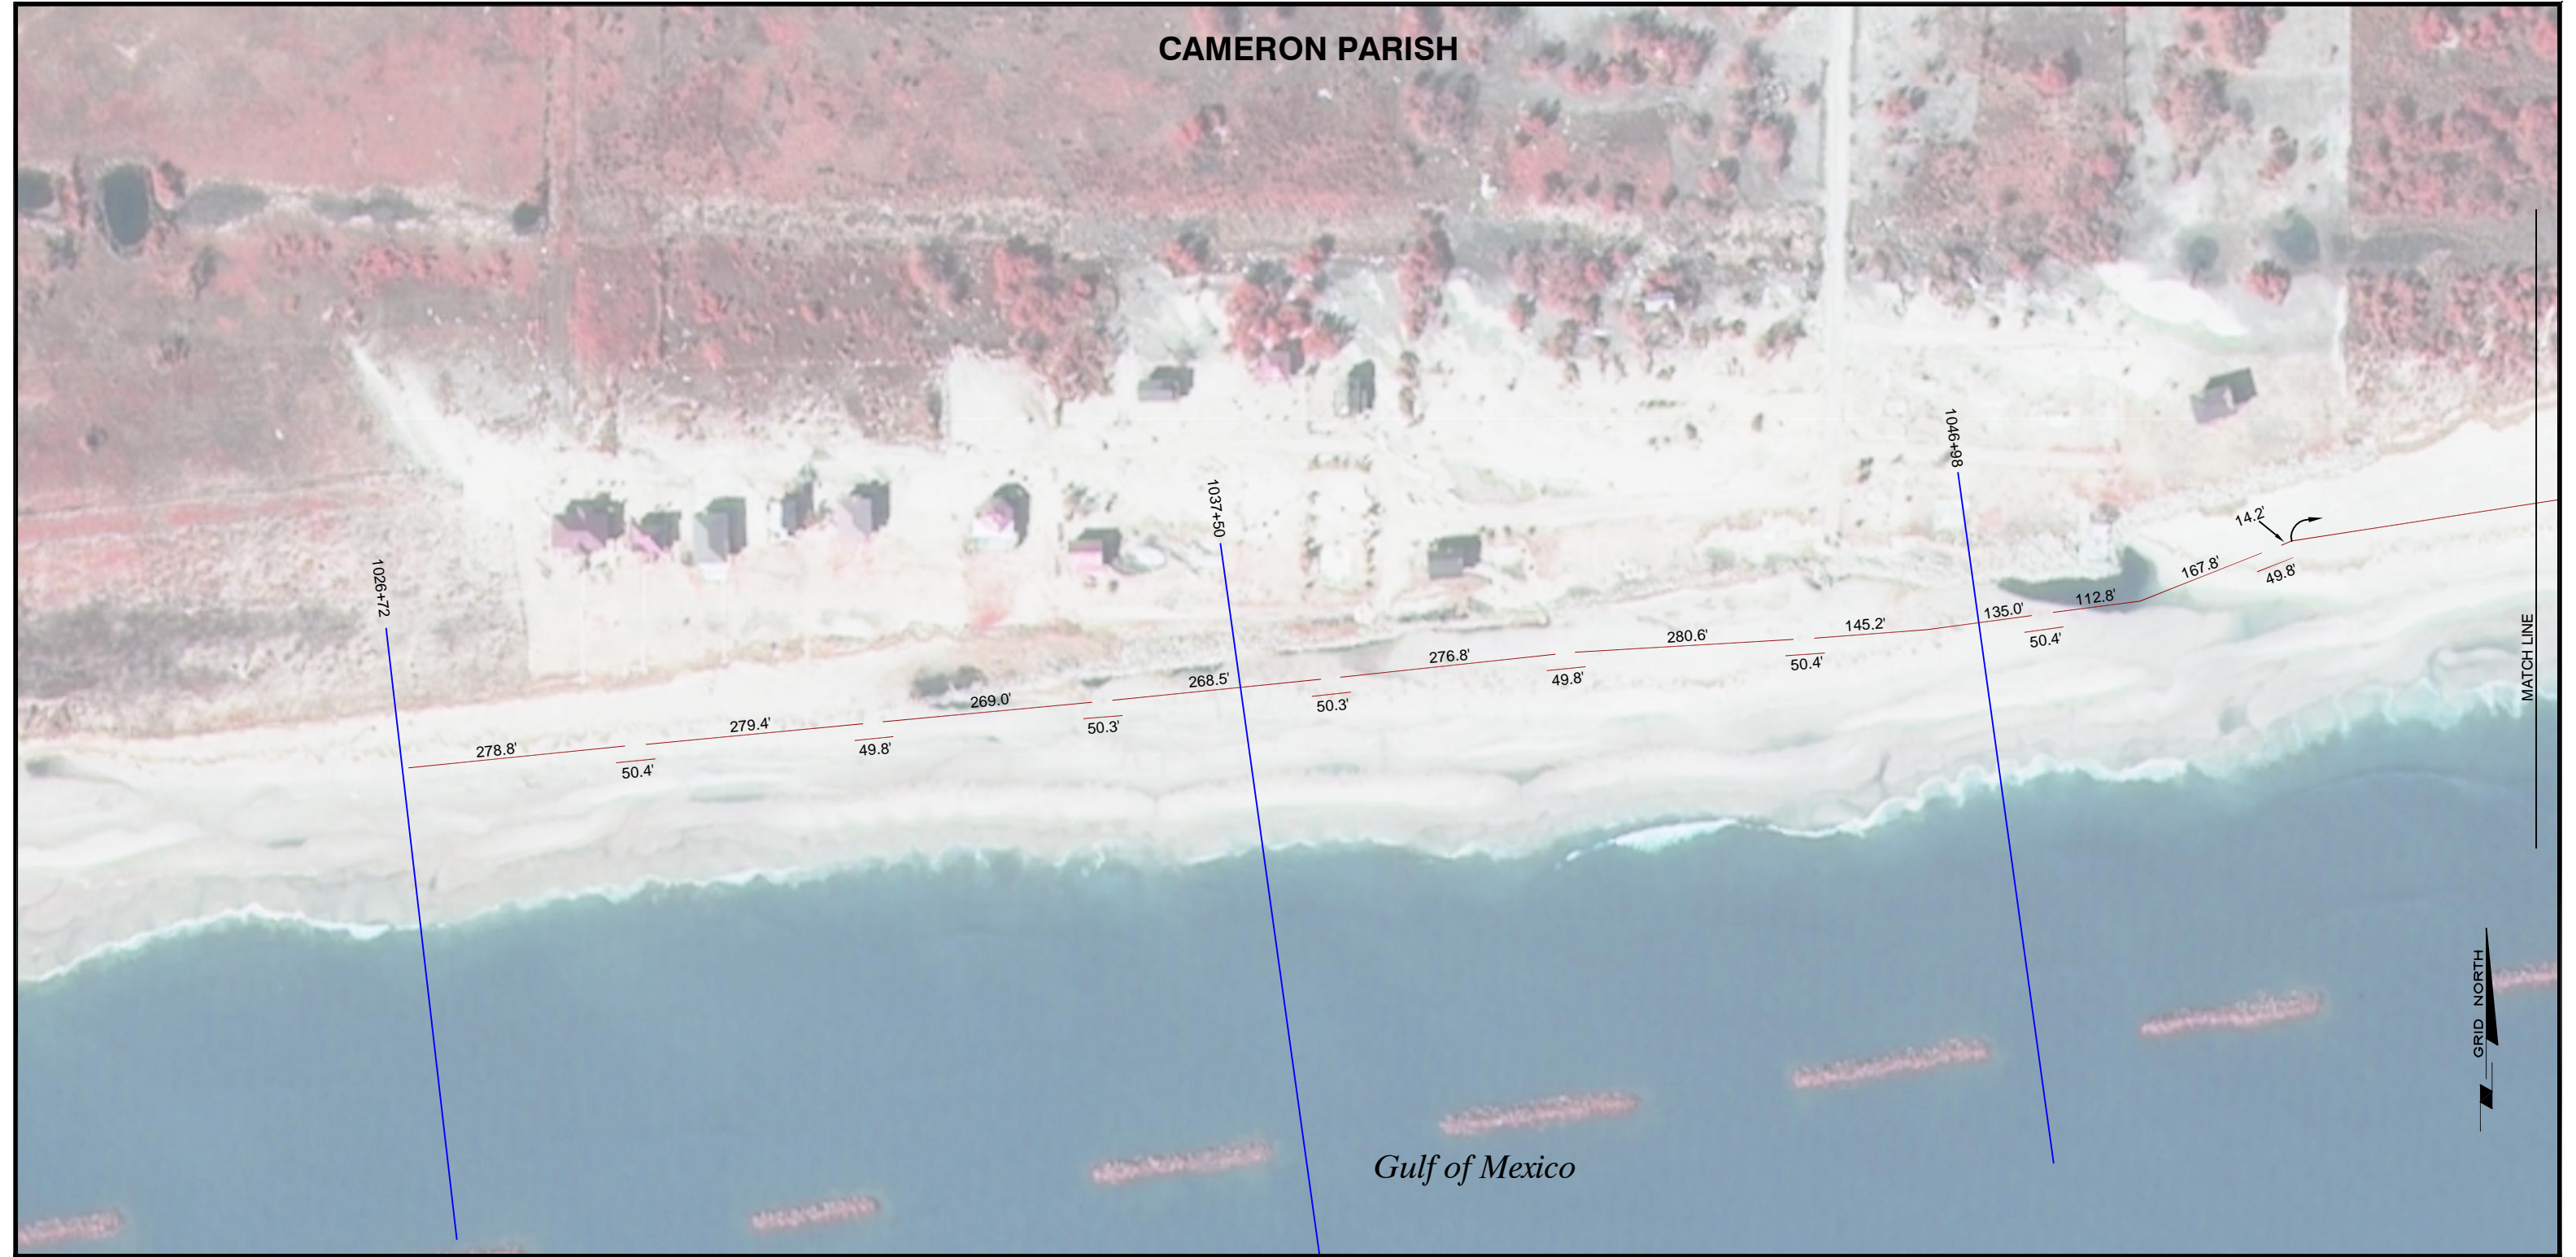

LEGEND:

- TRANSECTS LINES (SURVEY DATA)
- AS-BUILT FENCING

NOTES:

SURVEY PERFORMED USING REAL-TIME KINEMATIC (RTK) SURVEY BASED AT GPS MONUMENTS "OCEAN" AND "CS01-SM-03" AS BASE STATIONS FOR DGPS CORRECTIONS.

ELEVATIONS ARE REFERENCED TO NAVD 88 (Geoid99).

TOTAL LENGTH OF AS-BUILT FENCING IS 46,236.7 FEET.



Louisiana Department of Natural Resources
COASTAL RESTORATION DIVISION

**HOLLY BEACH SAND MANAGEMENT (CS-31)
AS-BUILT SAND FENCE REPAIRS**

CONTRACT 2503-05-31
CAMERON PARISH, LOUISIANA
GULF OF MEXICO

JOHN CHANCE
LAND SURVEYS, INC.



GEODETIC DATUM: NAD83
PROJECTION: LOUISIANA SOUTH
GRID UNITS: US SURVEY FEET



SCALE
IN FEET 0 200'

Job No.: 06-0207
Date: 1/18/07
Dwgfile: L:\...\HollyBeachBaseMap_11X17

Drwn: BPM

Chart: Of:
1 9

Proj. Mgr.: RMJ
Revised:
Printed: 1/19/07

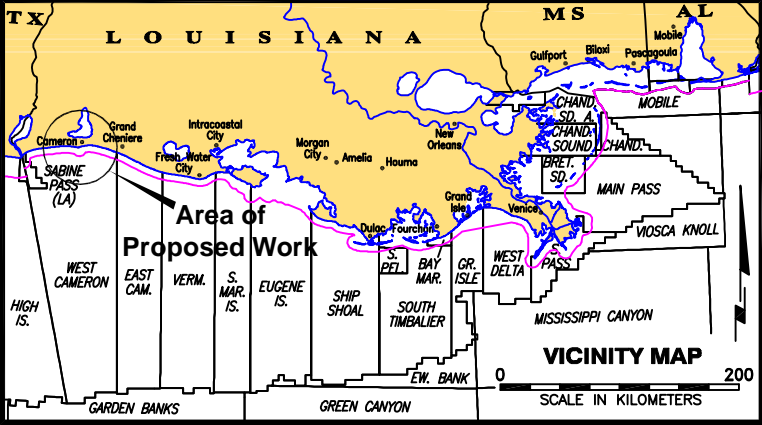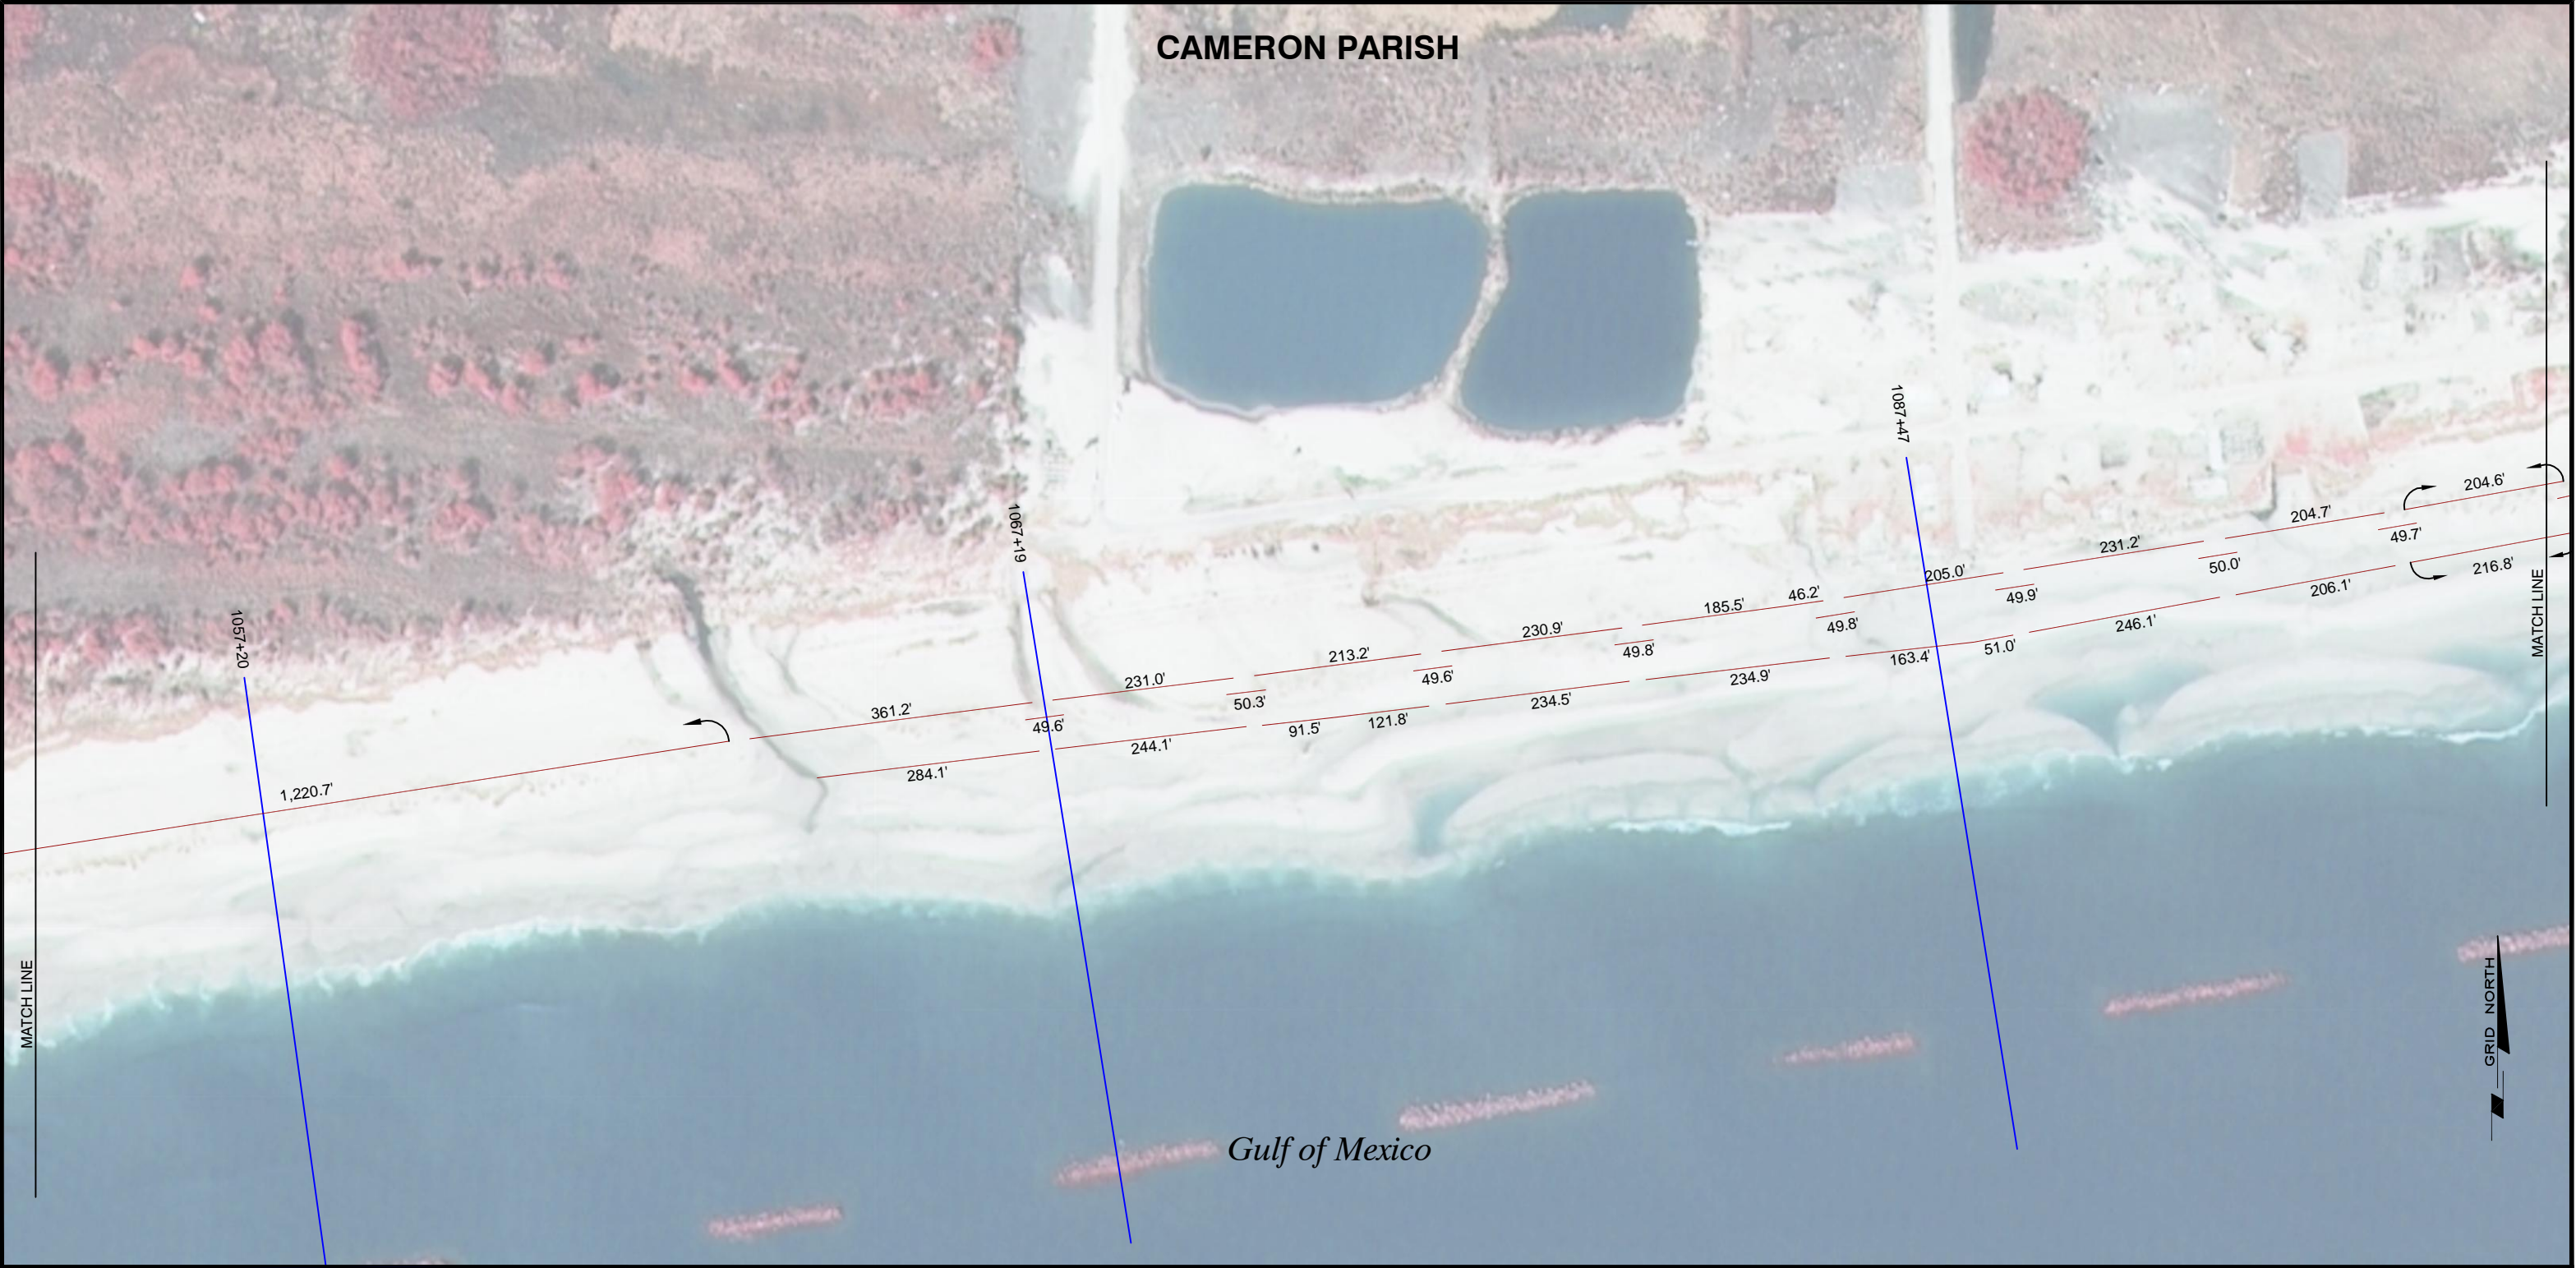

- LEGEND:**
- TRANSECTS LINES (SURVEY DATA)
 - AS-BUILT FENCING

NOTES:
SURVEY PERFORMED USING REAL-TIME KINEMATIC (RTK) SURVEY BASED AT GPS MONUMENTS "OCEAN" AND "CS01-SM-03" AS BASE STATIONS FOR DGPS CORRECTIONS.
ELEVATIONS ARE REFERENCED TO NAVD 88 (Geoid99).
TOTAL LENGTH OF AS-BUILT FENCING IS 46,236.7 FEET.



Louisiana Department of Natural Resources
COASTAL RESTORATION DIVISION

HOLLY BEACH SAND MANAGEMENT (CS-31)
AS-BUILT SAND FENCE REPAIRS

CONTRACT 2503-05-31
CAMERON PARISH, LOUISIANA
GULF OF MEXICO

JOHN CHANCE
LAND SURVEYS, INC.



GEODETIC DATUM: NAD83
PROJECTION: LOUISIANA SOUTH
GRID UNITS: US SURVEY FEET


SCALE
IN FEET 0 200'

Proj. Mgr.: RMJ
Revised:
Printed: 1/19/07


Job No.: 06-0207 Date: 1/18/07
Dwgnfile: L:\...\HollyBeachBaseMap_11X17

Drwn: BPM Chart: Of:
2 9

CAMERON PARISH

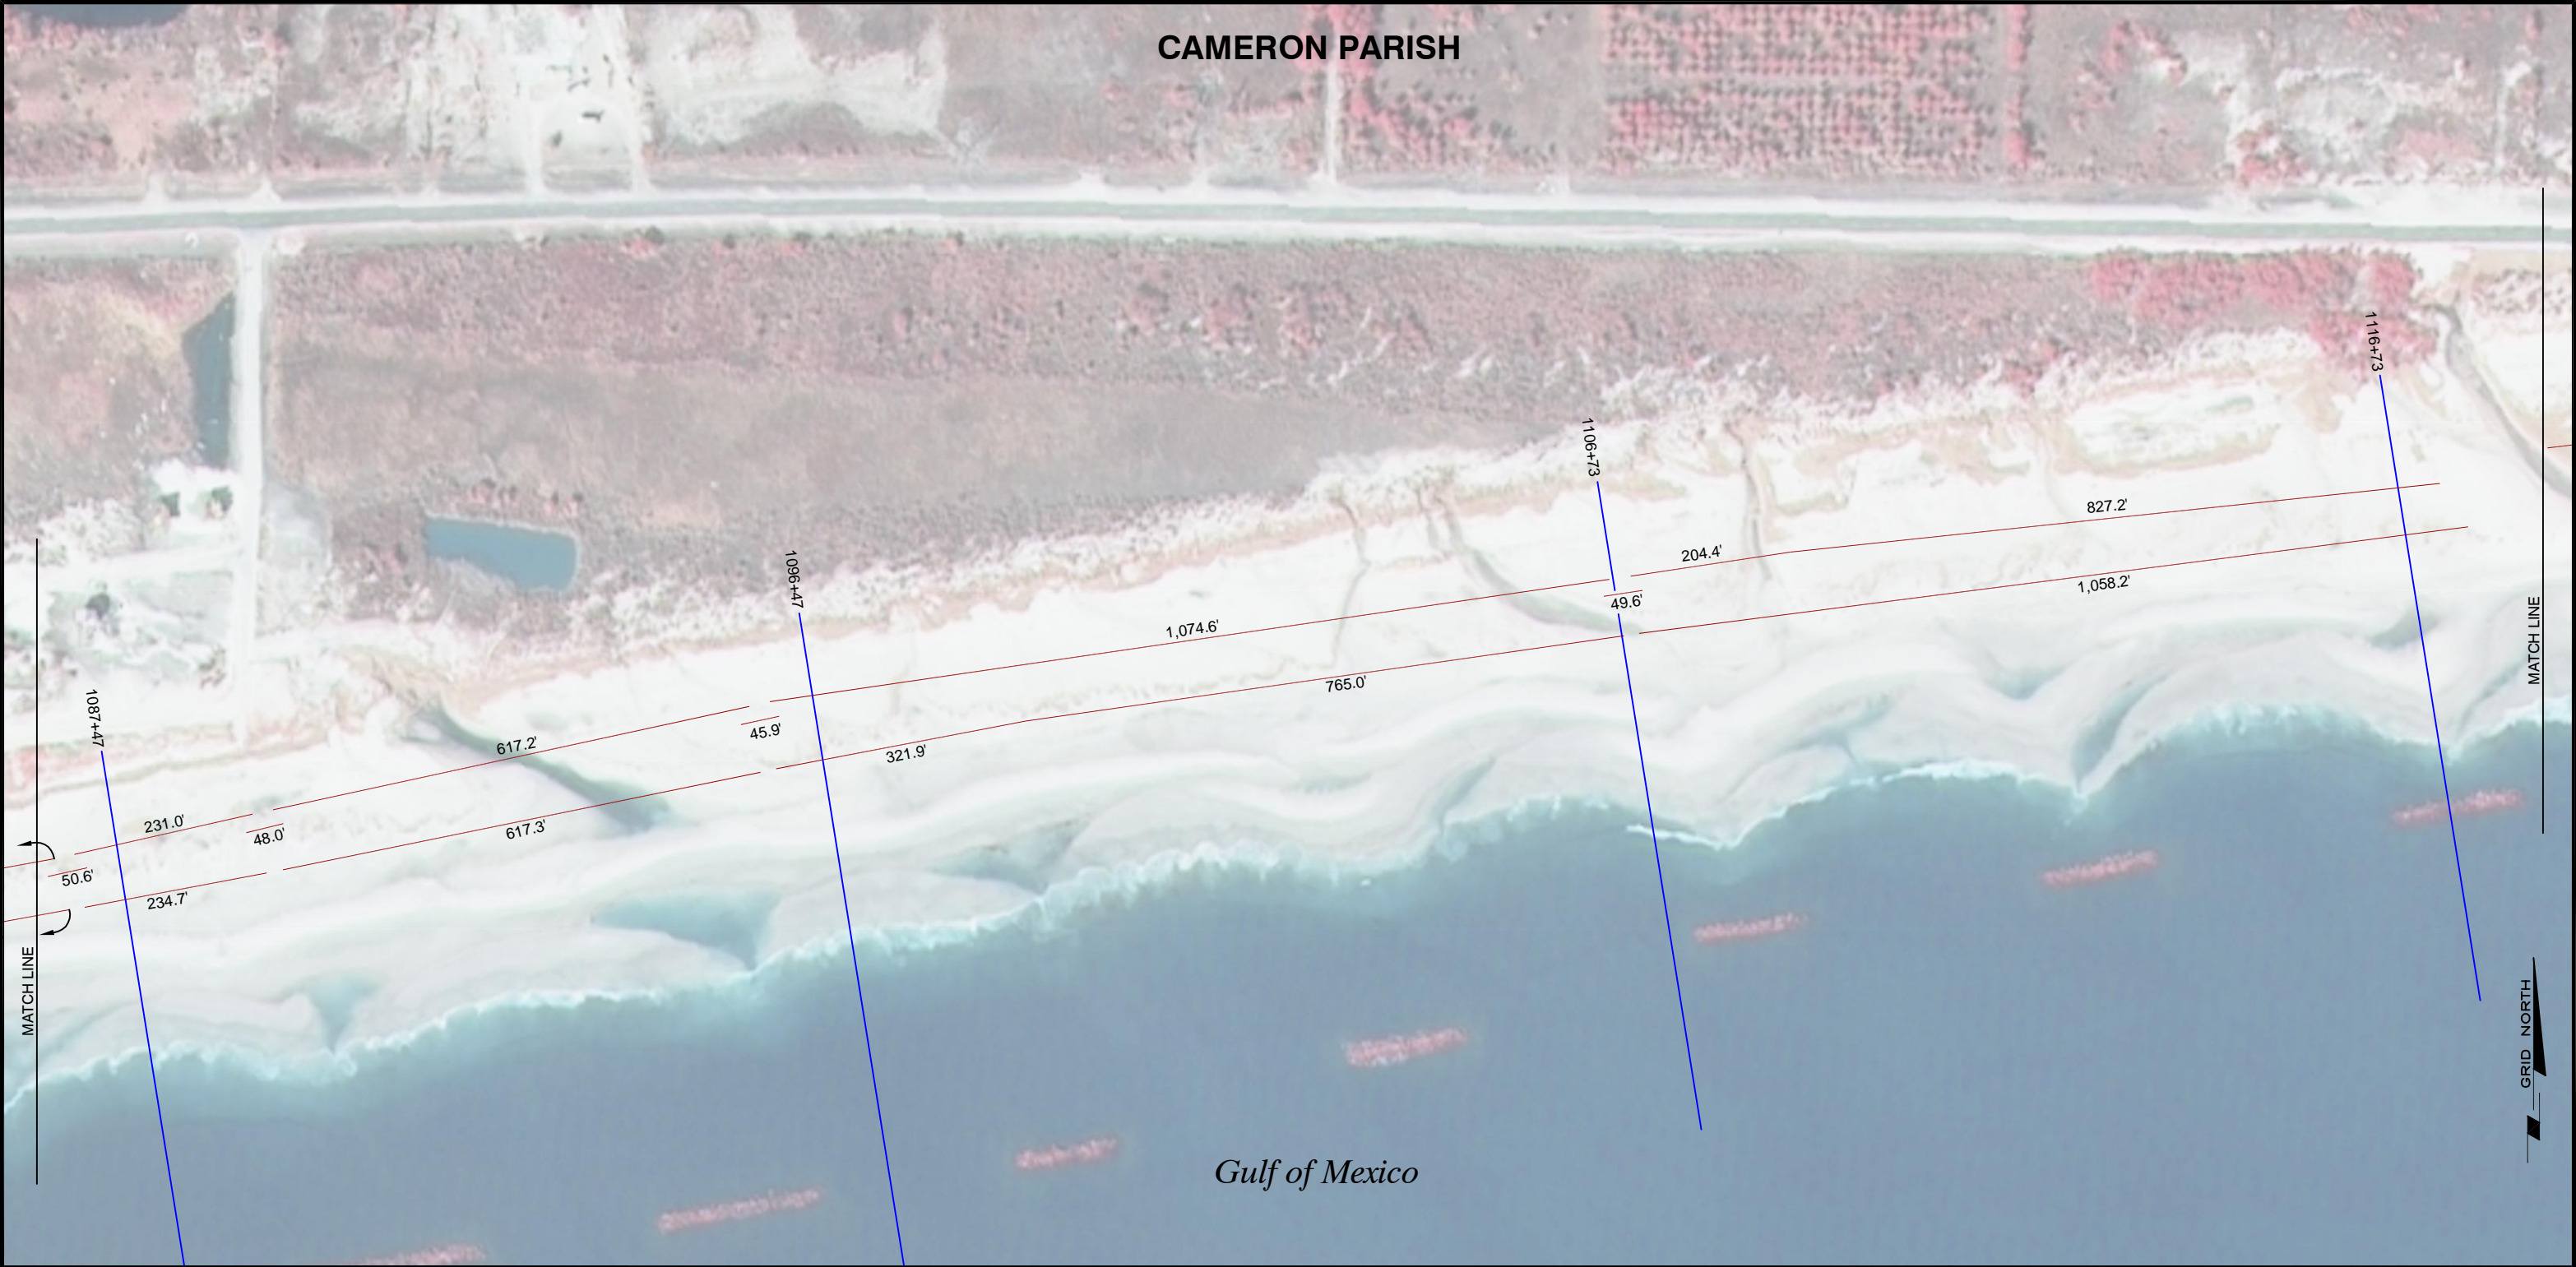

Gulf of Mexico

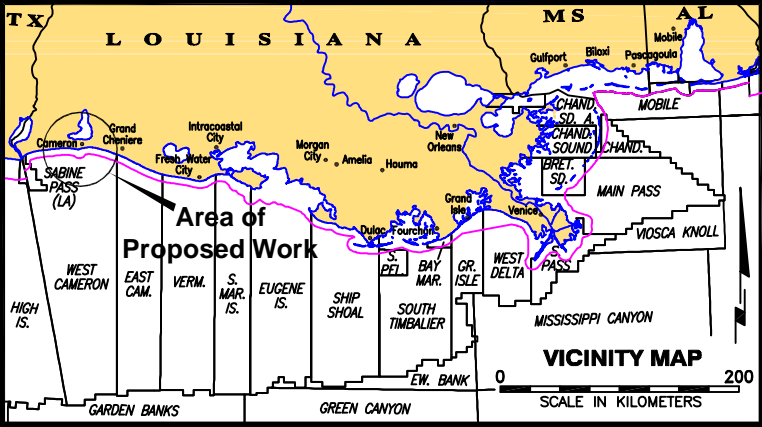

LEGEND:

- TRANSECTS LINES (SURVEY DATA)
- AS-BUILT FENCING

NOTES:
SURVEY PERFORMED USING REAL-TIME KINEMATIC (RTK) SURVEY BASED AT GPS MONUMENTS "OCEAN" AND "CS01-SM-03" AS BASE STATIONS FOR DGPS CORRECTIONS.
ELEVATIONS ARE REFERENCED TO NAVD 88 (Geoid99).
TOTAL LENGTH OF AS-BUILT FENCING IS 46,236.7 FEET.



Louisiana Department of Natural Resources
COASTAL RESTORATION DIVISION

**HOLLY BEACH SAND MANAGEMENT (CS-31)
AS-BUILT SAND FENCE REPAIRS**

CONTRACT 2503-05-31
CAMERON PARISH, LOUISIANA
GULF OF MEXICO

JOHN CHANCE
LAND SURVEYS, INC.



GEODETIC DATUM: NAD83
PROJECTION: LOUISIANA SOUTH
GRID UNITS: US SURVEY FEET


SCALE
IN FEET
0 200'

Proj. Mgr.: RMJ
Revised:
Printed: 1/19/07


Job No.: 06-0207
Date: 1/18/07
Dwgnfile: L:\...\HollyBeachBaseMap_11X17

Drwn: BPM
Chart: Of:
3 9

CAMERON PARISH

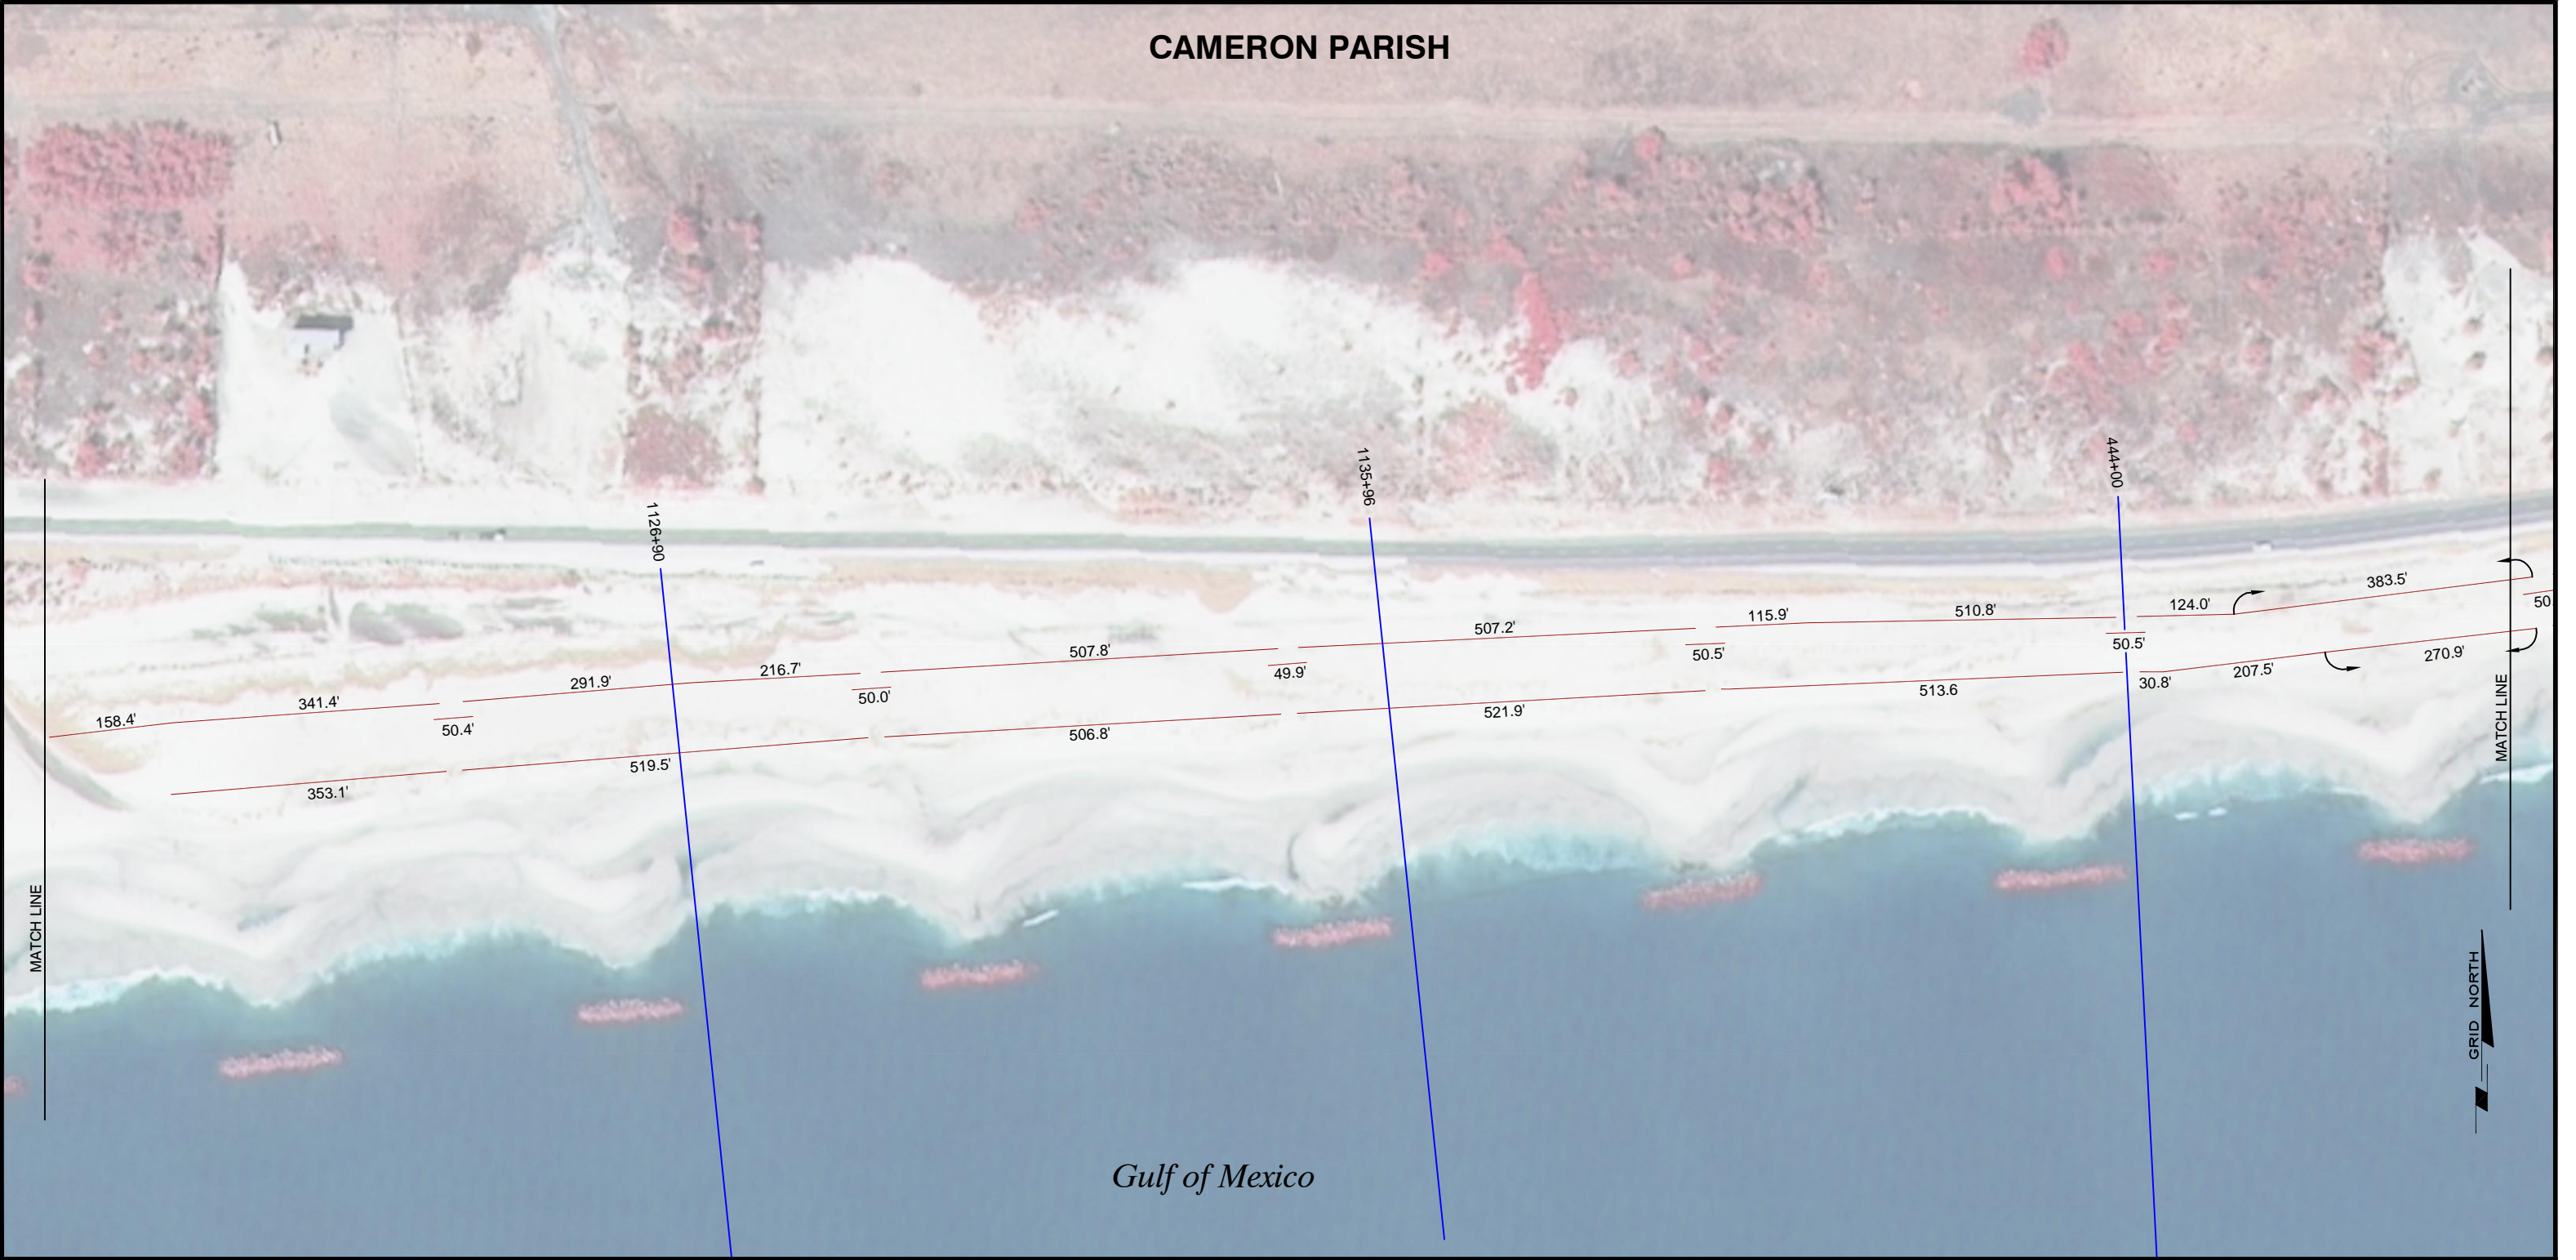

Gulf of Mexico

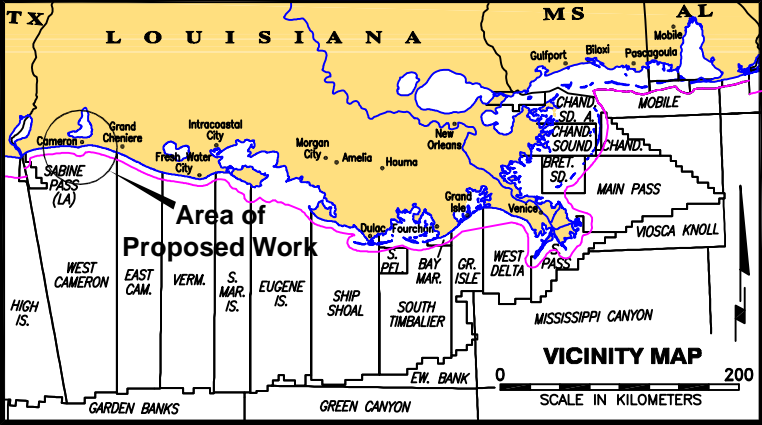

LEGEND:

- TRANSECTS LINES (SURVEY DATA)
- AS-BUILT FENCING

NOTES:
SURVEY PERFORMED USING REAL-TIME KINEMATIC (RTK) SURVEY BASED AT GPS MONUMENTS "OCEAN" AND "CS01-SM-03" AS BASE STATIONS FOR DGPS CORRECTIONS.
ELEVATIONS ARE REFERENCED TO NAVD 88 (Geoid99).
TOTAL LENGTH OF AS-BUILT FENCING IS 46,236.7 FEET.



Louisiana Department of Natural Resources
COASTAL RESTORATION DIVISION

**HOLLY BEACH SAND MANAGEMENT (CS-31)
AS-BUILT SAND FENCE REPAIRS**

CONTRACT 2503-05-31
CAMERON PARISH, LOUISIANA
GULF OF MEXICO

JOHN CHANCE
LAND SURVEYS, INC.



GEODETIC DATUM: NAD83
PROJECTION: LOUISIANA SOUTH
GRID UNITS: US SURVEY FEET

SCALE
IN FEET
0 200'

Job No.: 06-0207

Date: 1/18/07



Drwn: BPM

Chart: Of:

Dwgfile: L:\...\HollyBeachBaseMap_11X17

Proj. Mgr.: RMJ
Revised:
Printed: 1/19/07


4 9

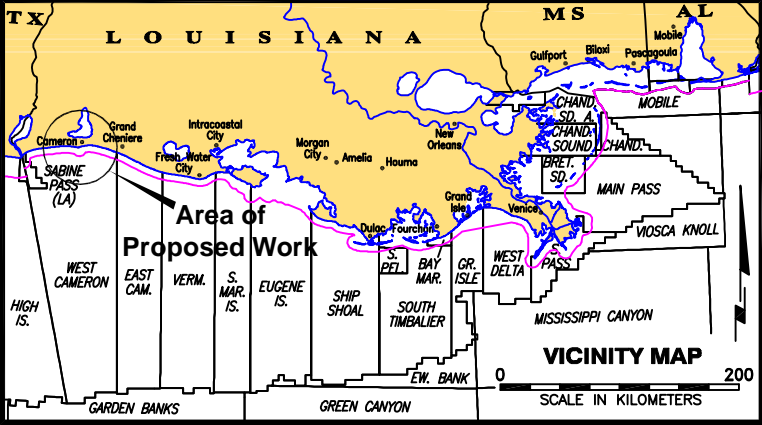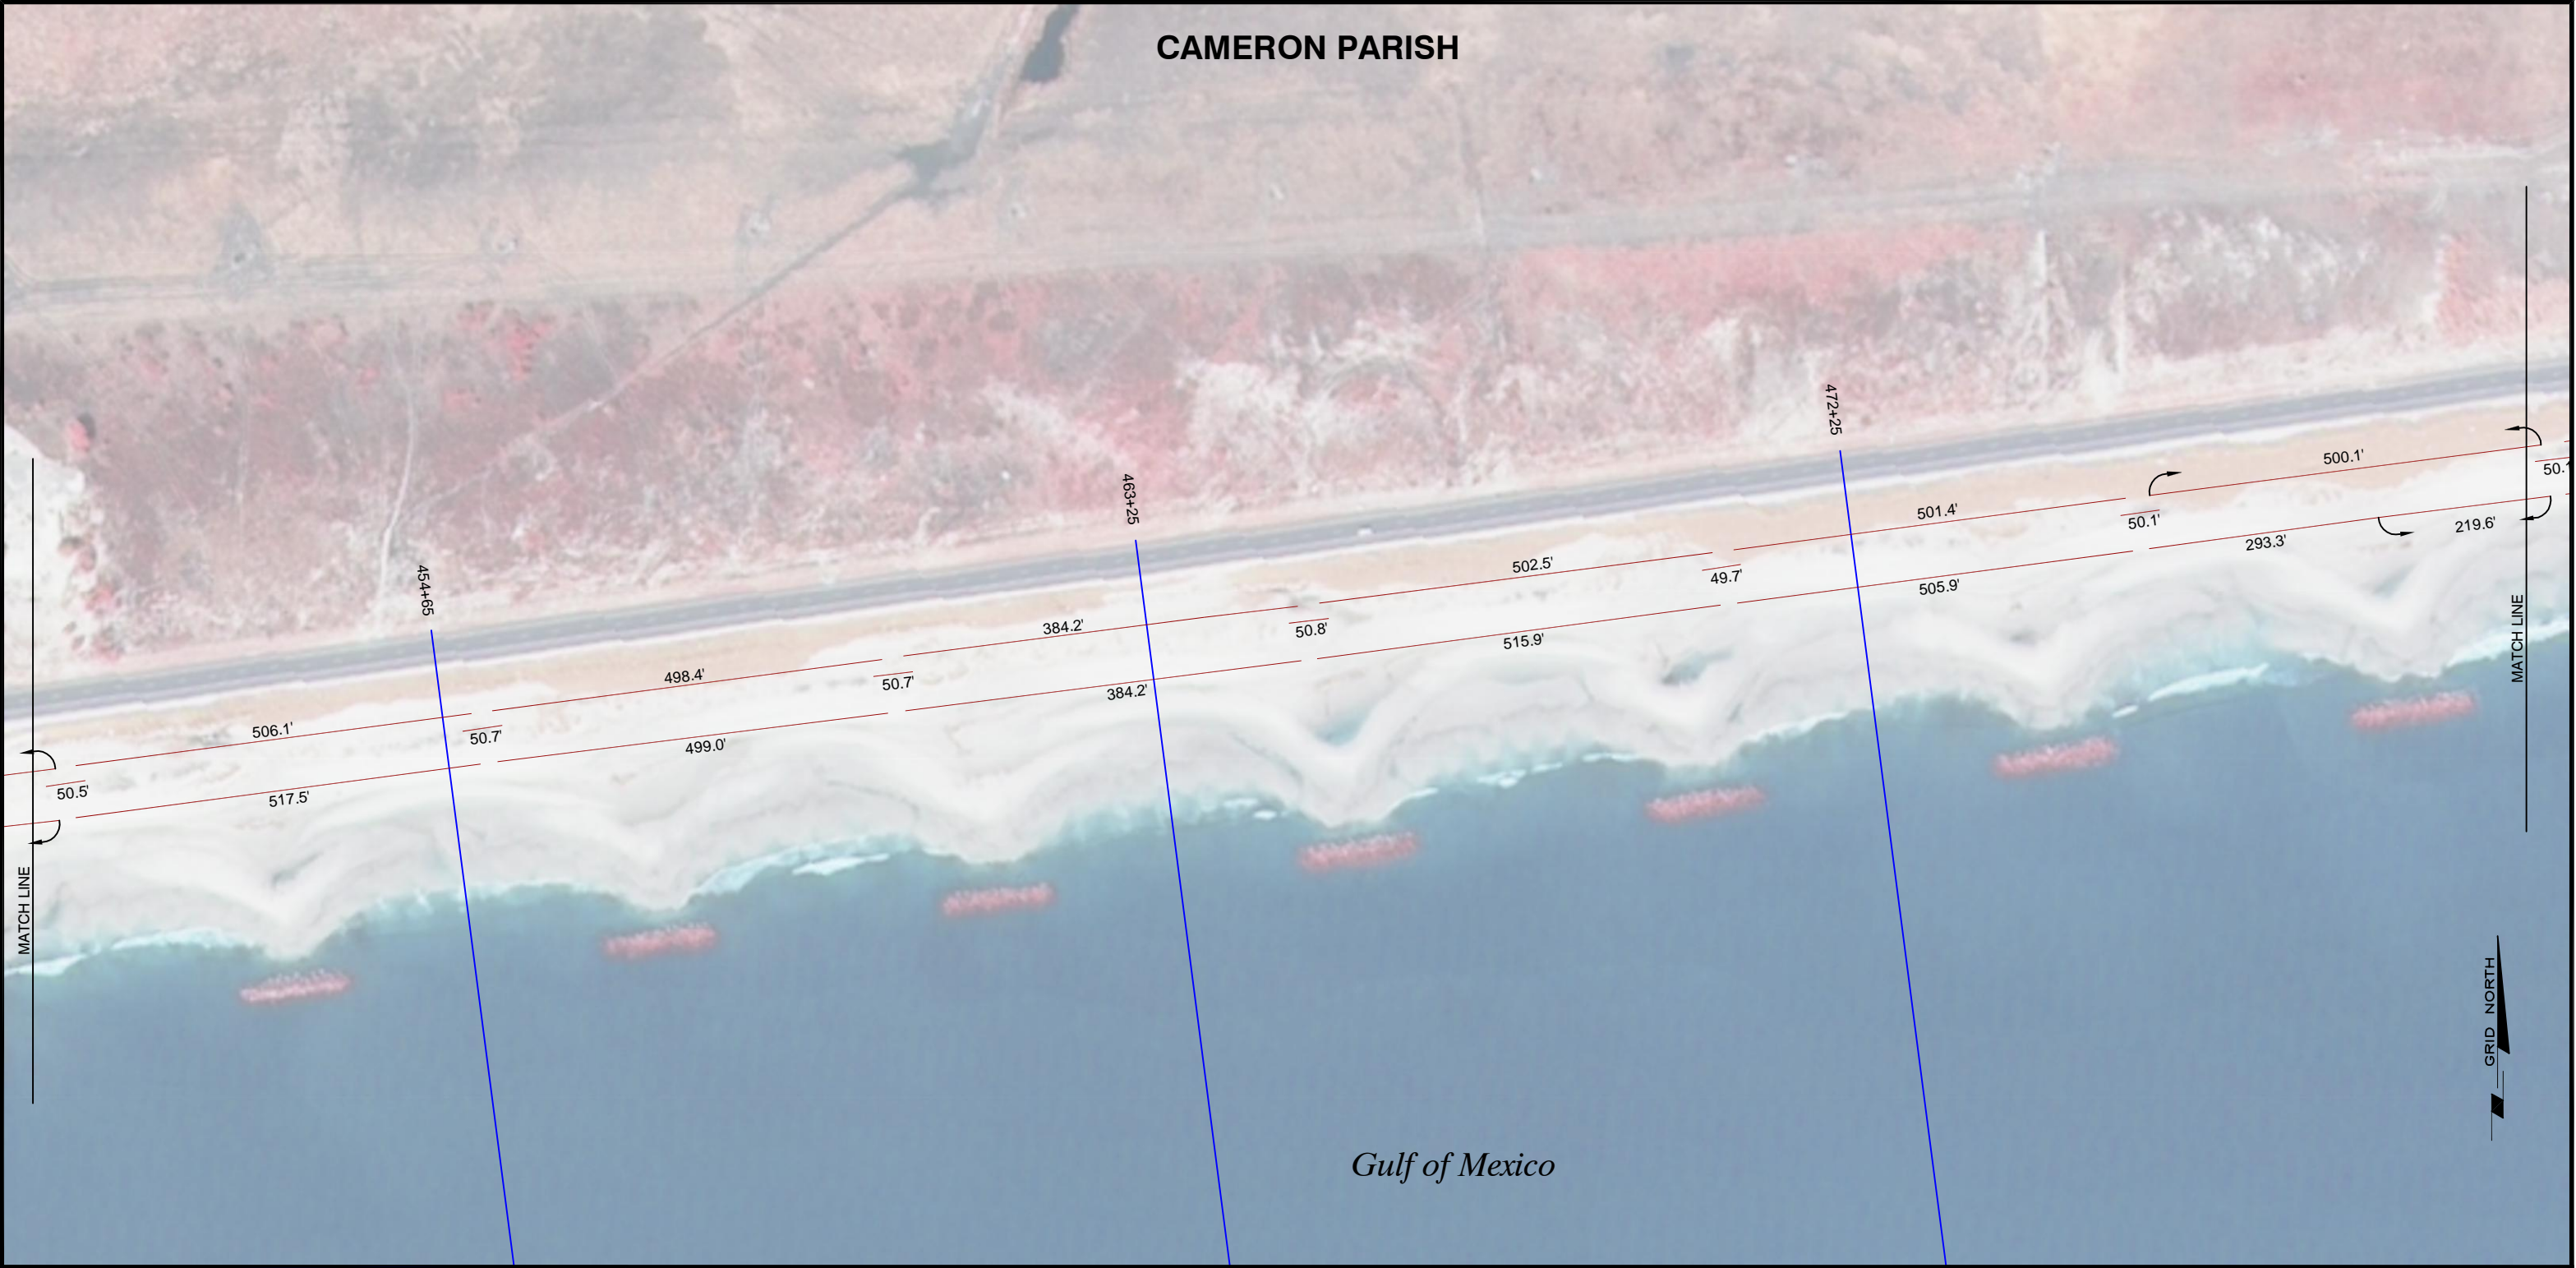

- LEGEND:**
- TRANSECTS LINES (SURVEY DATA)
 - AS-BUILT FENCING

NOTES:
SURVEY PERFORMED USING REAL-TIME KINEMATIC (RTK) SURVEY BASED AT GPS MONUMENTS "OCEAN" AND "CS01-SM-03" AS BASE STATIONS FOR DGPS CORRECTIONS.
ELEVATIONS ARE REFERENCED TO NAVD 88 (Geoid99).
TOTAL LENGTH OF AS-BUILT FENCING IS 46,236.7 FEET.

Proj. Mgr.: RMJ
Revised:
Printed: 1/19/07




Louisiana Department of Natural Resources
COASTAL RESTORATION DIVISION

HOLLY BEACH SAND MANAGEMENT (CS-31)
AS-BUILT SAND FENCE REPAIRS

CONTRACT 2503-05-31
CAMERON PARISH, LOUISIANA
GULF OF MEXICO

JOHN CHANCE
LAND SURVEYS, INC.



GEODETIC DATUM: NAD83
PROJECTION: LOUISIANA SOUTH
GRID UNITS: US SURVEY FEET



SCALE
IN FEET

0 200'

Job No.: 06-0207
Date: 1/18/07
Dwgn: BPM

Chart: Of:
5 9

CAMERON PARISH

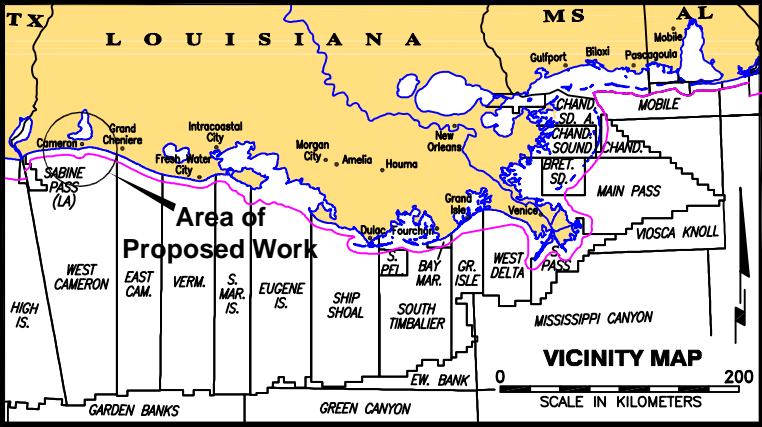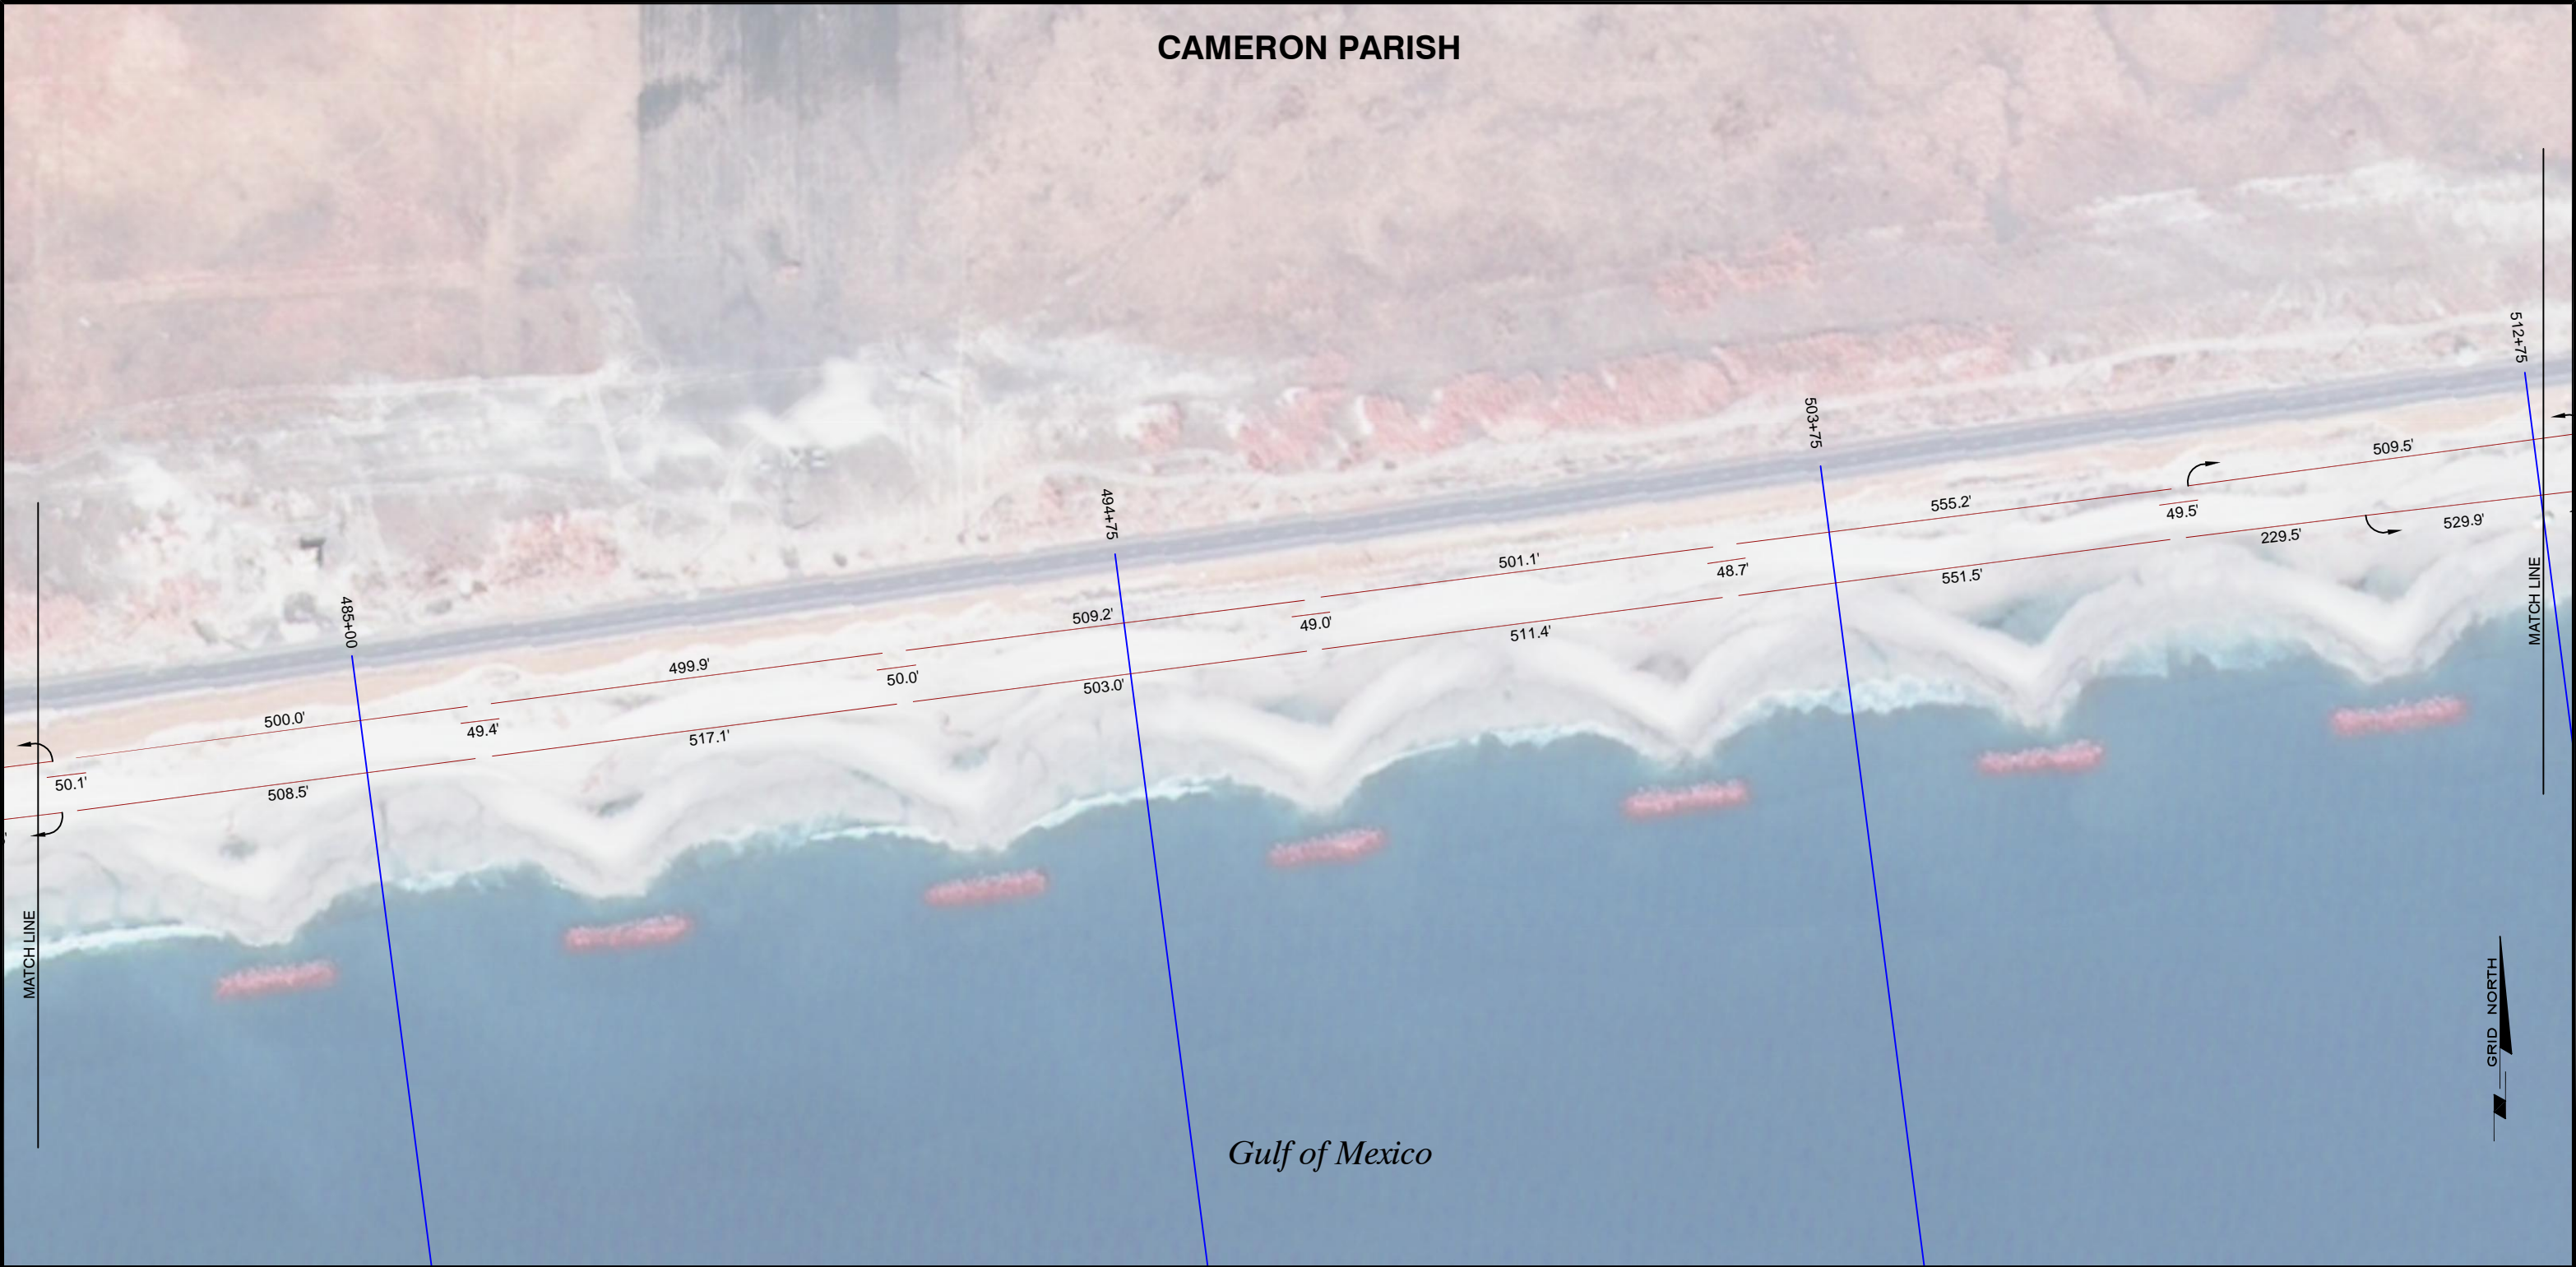

LEGEND:

- TRANSECTS LINES (SURVEY DATA)
- AS-BUILT FENCING

NOTES:
SURVEY PERFORMED USING REAL-TIME KINEMATIC (RTK) SURVEY BASED AT GPS MONUMENTS "OCEAN" AND "CS01-SM-03" AS BASE STATIONS FOR DGPS CORRECTIONS.
ELEVATIONS ARE REFERENCED TO NAVD 88 (Geoid99).
TOTAL LENGTH OF AS-BUILT FENCING IS 46,236.7 FEET.



Louisiana Department of Natural Resources
COASTAL RESTORATION DIVISION

**HOLLY BEACH SAND MANAGEMENT (CS-31)
AS-BUILT SAND FENCE REPAIRS**

CONTRACT 2503-05-31
CAMERON PARISH, LOUISIANA
GULF OF MEXICO

JOHN CHANCE
LAND SURVEYS, INC.



GEODETIC DATUM: NAD83
PROJECTION: LOUISIANA SOUTH
GRID UNITS: US SURVEY FEET

SCALE
IN FEET
0 200'

Job No.: 06-0207

Date: 1/18/07



Drwn: BPM

Chart: Of:

Dwgfile: L:\...\HollyBeachBaseMap_11X17

Proj. Mgr.: RMJ
Revised:
Printed: 1/19/07

CAMERON PARISH

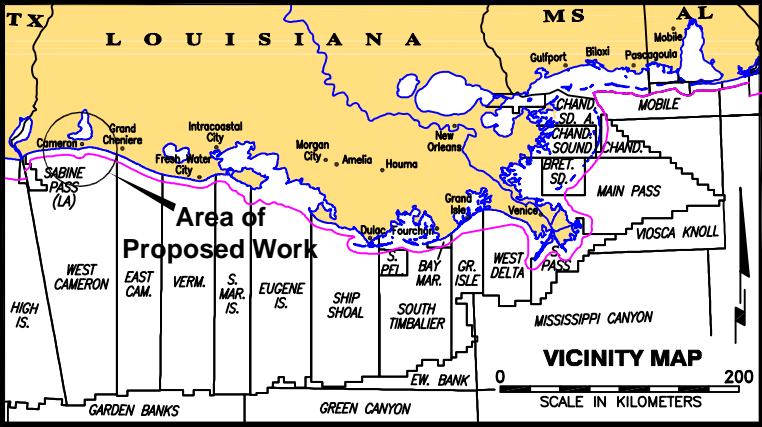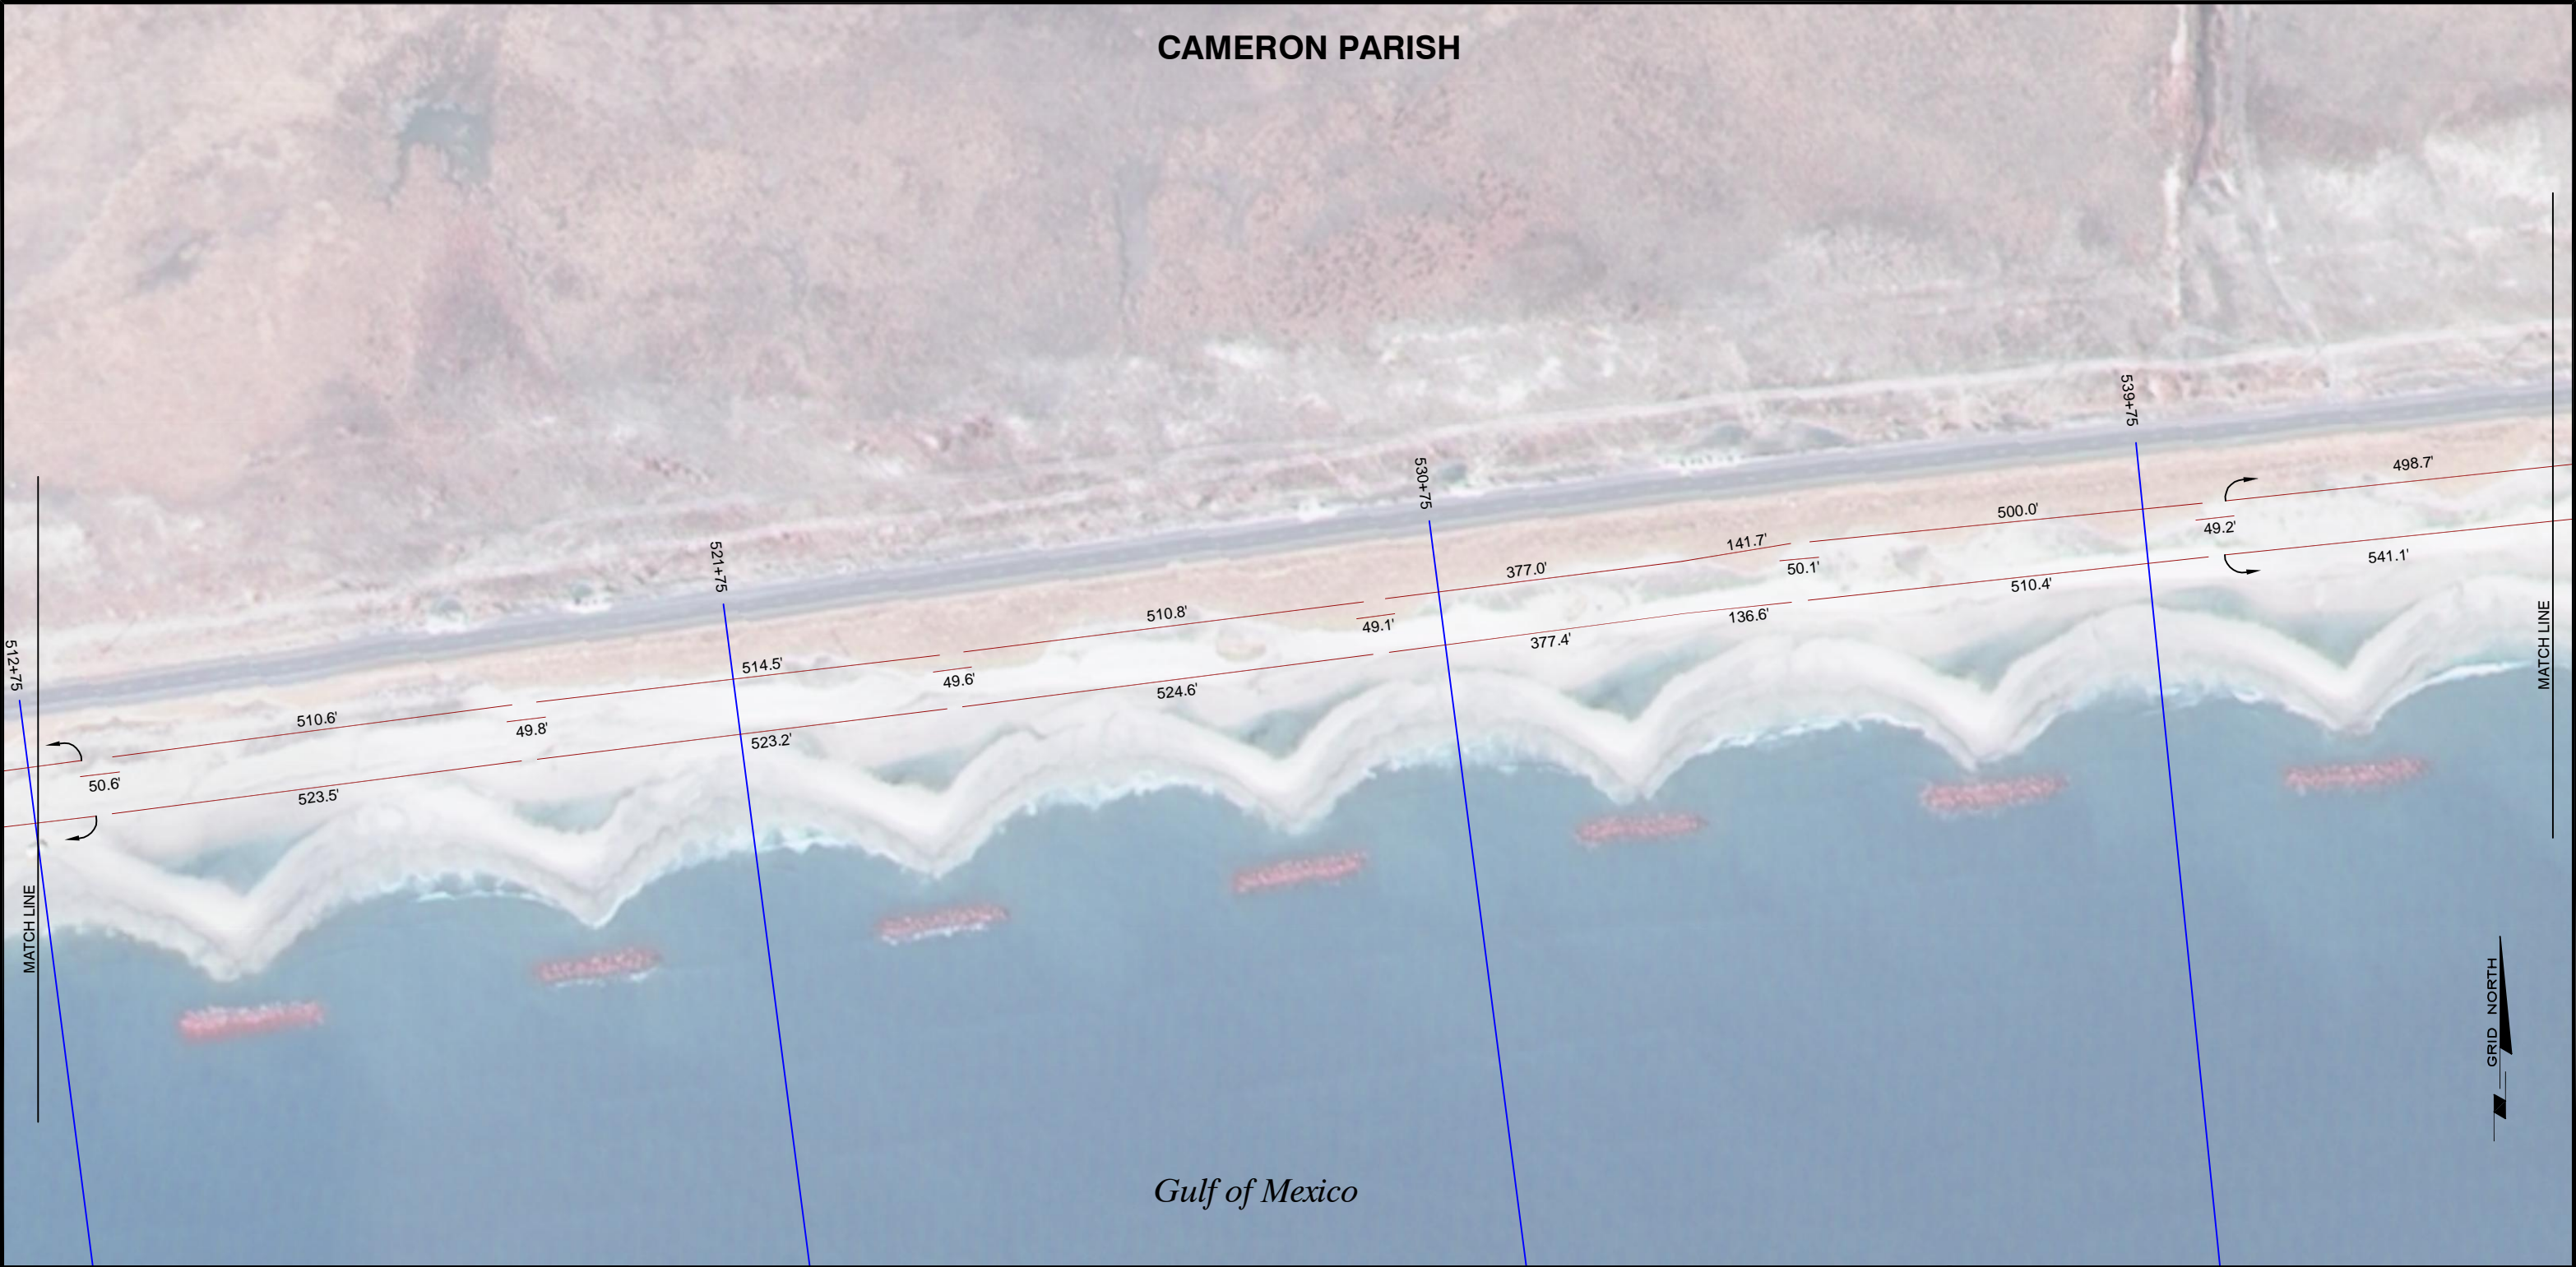

LEGEND:

- TRANSECTS LINES (SURVEY DATA)
- AS-BUILT FENCING

NOTES:
SURVEY PERFORMED USING REAL-TIME KINEMATIC (RTK) SURVEY BASED AT GPS MONUMENTS "OCEAN" AND "CS01-SM-03" AS BASE STATIONS FOR DGPS CORRECTIONS.
ELEVATIONS ARE REFERENCED TO NAVD 88 (Geoid99).
TOTAL LENGTH OF AS-BUILT FENCING IS 46,236.7 FEET.



Louisiana Department of Natural Resources
COASTAL RESTORATION DIVISION

**HOLLY BEACH SAND MANAGEMENT (CS-31)
AS-BUILT SAND FENCE REPAIRS**

CONTRACT 2503-05-31
CAMERON PARISH, LOUISIANA
GULF OF MEXICO

JOHN CHANCE
LAND SURVEYS, INC.



GEODETIC DATUM: NAD83
PROJECTION: LOUISIANA SOUTH
GRID UNITS: US SURVEY FEET

SCALE
IN FEET
0 200'

Job No.: 06-0207

Date: 1/18/07


Drwn: BPM

Chart: Of:

Dwgfile: L:\...\HollyBeachBaseMap_11X17

Proj. Mgr.: RMJ
Revised:
Printed: 1/19/07

CAMERON PARISH

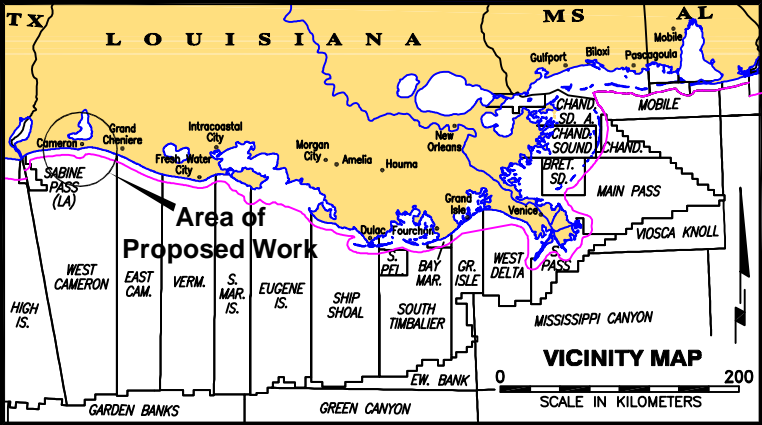

LEGEND:

- TRANSECTS LINES (SURVEY DATA)
- AS-BUILT FENCING

NOTES:
SURVEY PERFORMED USING REAL-TIME KINEMATIC (RTK) SURVEY BASED AT GPS MONUMENTS "OCEAN" AND "CS01-SM-03" AS BASE STATIONS FOR DGPS CORRECTIONS.
ELEVATIONS ARE REFERENCED TO NAVD 88 (Geoid99).
TOTAL LENGTH OF AS-BUILT FENCING IS 46,236.7 FEET.



Louisiana Department of Natural Resources
COASTAL RESTORATION DIVISION

**HOLLY BEACH SAND MANAGEMENT (CS-31)
AS-BUILT SAND FENCE REPAIRS**

CONTRACT 2503-05-31
CAMERON PARISH, LOUISIANA
GULF OF MEXICO

JOHN CHANCE
LAND SURVEYS, INC.



GEODETIC DATUM: NAD83
PROJECTION: LOUISIANA SOUTH
GRID UNITS: US SURVEY FEET

SCALE
IN FEET
0 200'

Job No.: 06-0207

Date: 1/18/07

Drwn: BPM


Chart: Of:

Dwgfile: L:\...\HollyBeachBaseMap_11X17

Proj. Mgr.: RMJ
Revised:
Printed: 1/19/07

8 9

CAMERON PARISH

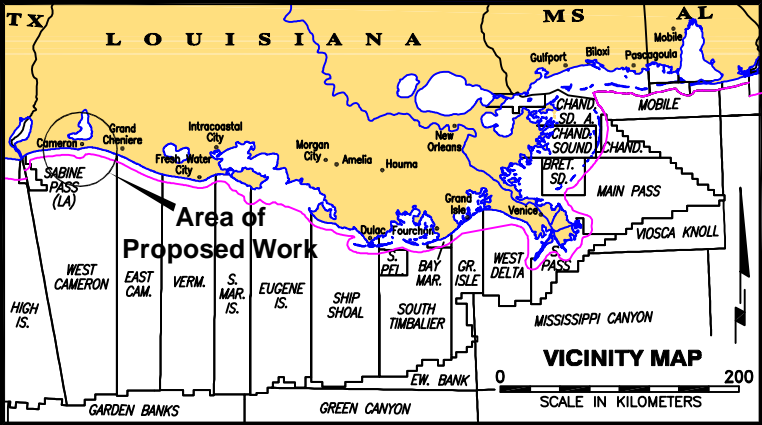

LEGEND:

- TRANSECTS LINES (SURVEY DATA)
- AS-BUILT FENCING

NOTES:
SURVEY PERFORMED USING REAL-TIME KINEMATIC (RTK) SURVEY BASED AT GPS MONUMENTS "OCEAN" AND "CS01-SM-03" AS BASE STATIONS FOR DGPS CORRECTIONS.
ELEVATIONS ARE REFERENCED TO NAVD 88 (Geoid99).
TOTAL LENGTH OF AS-BUILT FENCING IS 46,236.7 FEET.



Louisiana Department of Natural Resources
COASTAL RESTORATION DIVISION

**HOLLY BEACH SAND MANAGEMENT (CS-31)
AS-BUILT SAND FENCE REPAIRS**

CONTRACT 2503-05-31
CAMERON PARISH, LOUISIANA
GULF OF MEXICO

JOHN CHANCE
LAND SURVEYS, INC.



GEODETIC DATUM: NAD83
PROJECTION: LOUISIANA SOUTH
GRID UNITS: US SURVEY FEET

SCALE
IN FEET
0 200'

Job No.: 06-0207

Date: 1/18/07

Drwn: BPM

Chart: Of:

Dwgfile: L:\...\HollyBeachBaseMap_11X17

Proj. Mgr.: RMJ
Revised:
Printed: 1/19/07

9 9